



**KF Aerospace
Centre for
Excellence**
5800 LAPOINTE DRIVE
KELOWNA, BC CANADA

To Whom This May Concern,

A liquor primary application has been submitted for the KF Aerospace Centre of Excellence, located at 5800 Lapointe Way.

The Centre of Excellence was built to celebrate the incredible history of achievement in Canadian aerospace. It debuts a state-of-the-art aviation museum and conference centre located at the Kelowna International Airport. Intended to welcome locals, and visitors, the Centre promotes the advancement of aviation in Kelowna, and beyond.

The liquor license will be on the second floor of the Centre which is where a café will be operating. Guests will have the ability to enjoy an alcoholic beverage and small bite to eat after touring the Centre of Excellence, or while waiting for a loved one to land at YLW. Hours of liquor service will be between noon and 5pm daily. Our license will allow a capacity of 127 guests, yet we anticipate staying within 60 guests due to a seated floorplan.

Any additional questions may be directed towards myself, by emailing p.quinn@kfaero.ca or by phone 250-491-5594.

I look forward to having you visit the KF Aerospace Centre of Excellence.

Sincerely,

Paula Quinn
Executive Director
KF Aerospace Centre of Excellence



ATTACHMENT B

This forms part of application
LL22-0007


Planner Initials **MT**



233 BERNARD AVENUE
KELOWNA, B.C.
V1Y 6H2
TEL: 250.762.3004
EMAIL: kel-mat@shaw.ca



2023-02-21
LIQUOR
LICENSE
GP-11608

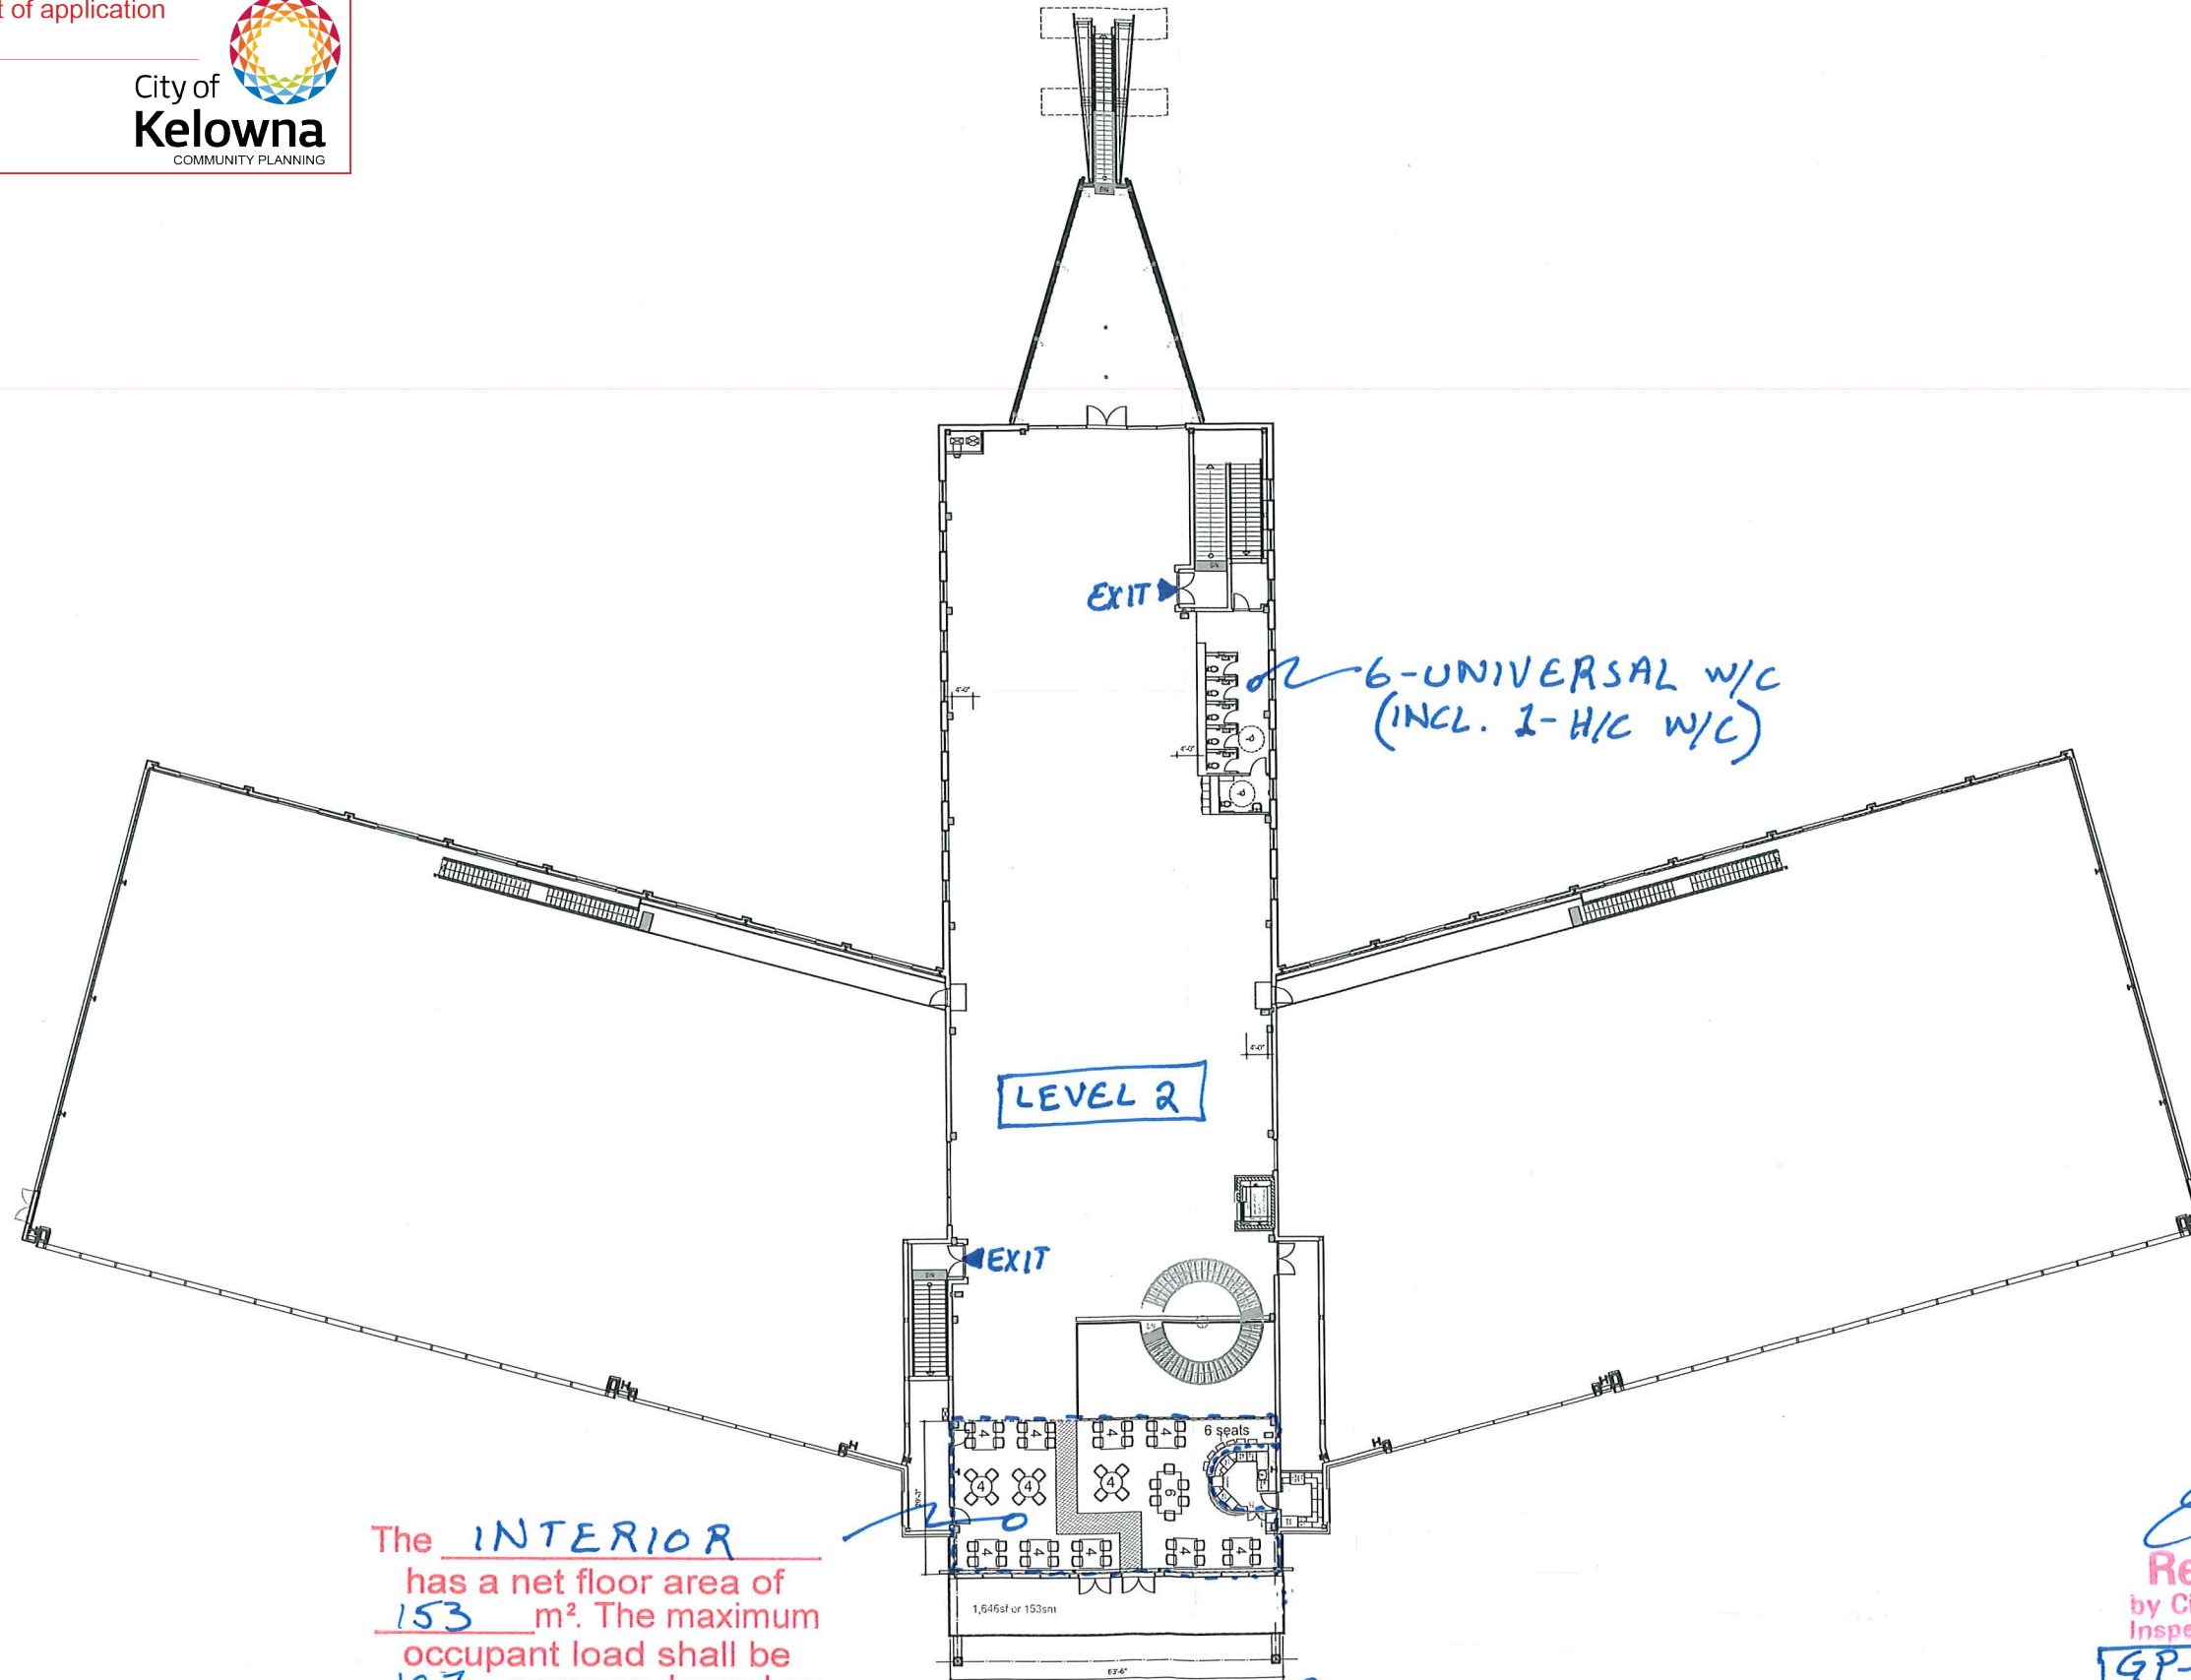

The INTERIOR
has a net floor area of
153 m². The maximum
occupant load shall be
127 persons, based on
1.2 m²/person
(SEATED OR STANDING)

INT. MAX. AREA = 153m²
PER ZONING BYLAW

[Signature]
Reviewed
by City of Kelowna
Inspection Services
GP-11608
2023-02-22



Copyright reserved. This plan and design is and
at all times remains the exclusive property of
Meiklejohn Architects Inc. and may not be used
without the Architects' consent.

No.	Date	Revision

Project Title
KF AEROSPACE
CENTRE FOR
EXCELLENCE
5800 LAPOINTE WAY, KELOWNA

Drawing Number

A3.11

DRAWINGS ARE NOT TO BE SCALED.
ALL DIMENSIONS SHALL BE VERIFIED ON JOB

Drawing Title
**LEVEL 2
LIQUOR LICENSE**

scale: 1/16"=1'0"

Date	2023-02-21
Job No.	19+M 18-1840
Scale	AS SHOWN
Drawn	SH
Checked	