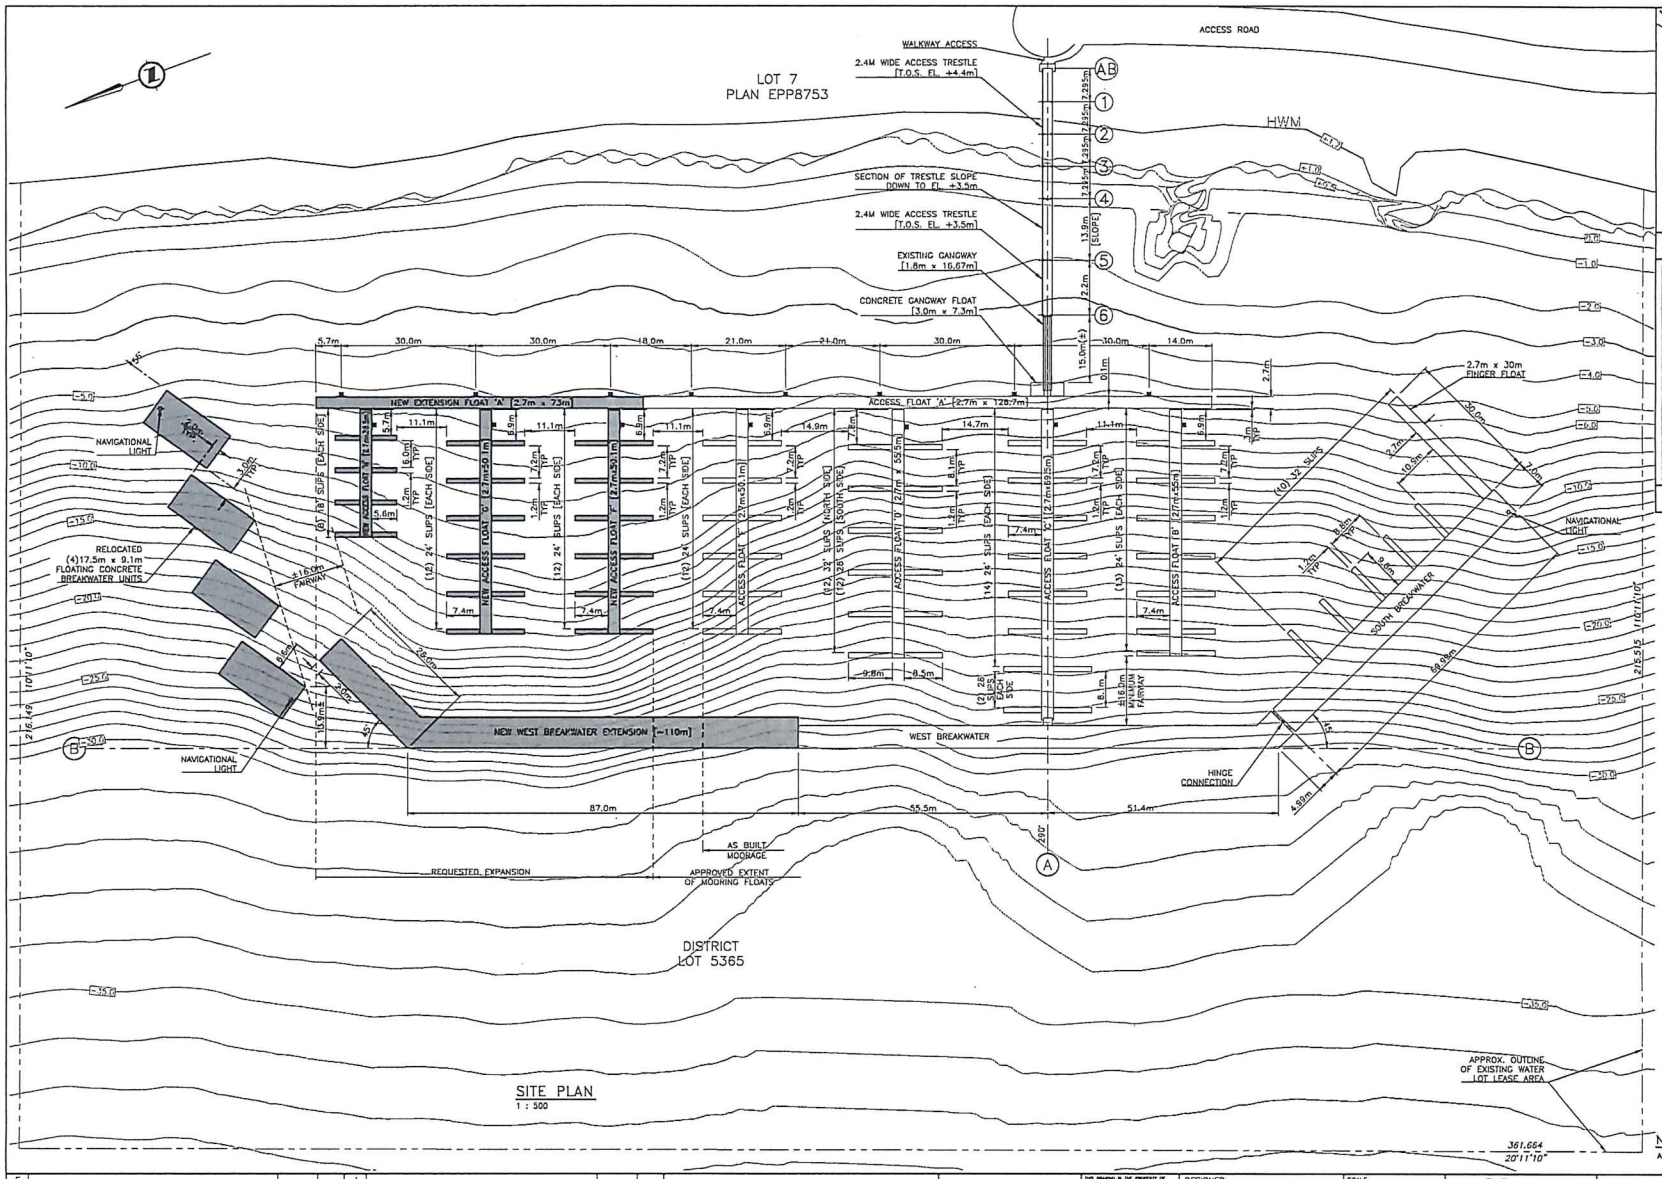

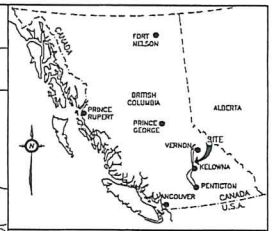

LOCATION PLAN

KEY PLAN

EXISTING MOORING CAPACITY		
BOAT SIZE	MOORING TYPE	NUMBER
18' BOATS	SLIPS	16
24' BOATS	SLIPS	128
28' BOATS	SLIPS	16
30' – 32' BOATS	SLIPS	22
NUMBER OF BOAT SLIPS		180

SCHEDULE A
PR 18-0002

NOTES:
ALL DIMENSIONS ARE IN METERS UNLESS NOTED OTHERWISE.

E				J					
D				I					
C				H					
B	AS BUILT UPDATED	10.03.18	A.P.	G					
A	ISSUED FOR PERMIT	10.04.17	A.P.	F					
REVISION				REVISION				REFERENCE DRAWINGS	

THIS DRAWING IS THE PROPERTY OF VILLHOLTH JENSEN & ASSOCIATES LTD. AND SHALL ONLY BE USED FOR THE PURPOSE TO WHICH IT REFERS. THIS DRAWING IS PROVIDED SOLELY FOR THE USE OF THE CLIENT NAMED BY VILLHOLTH JENSEN & ASSOCIATES LTD. THIS DRAWING HAS BEEN PREPARED AND THERE ARE NO REPRESENTATIONS OF ANY KIND MADE BY VILLHOLTH JENSEN & ASSOCIATES LTD. TO ANY PARTY WITH WHOM VILLHOLTH JENSEN & ASSOCIATES LTD. HAS NOT ENTERED INTO A CONTRACT.

DESIGNED:	A.P.	SCALE:	1 : 500
DRAWN:	P.D.M.	FILE No.	217111-101
CHECKED:	A.P.	CAD FILE NAME:	217111-101
APPROVED:		PROJECT No.	217111

VJA ENGINEERING
VILLHOLTH JENSEN & ASSOC. LTD.
CONSULTING ENGINEERS
VANCOUVER, B.C.

McKINLEY HILLSIDE LIMITED PARTNERSHIP

McKINLEY BEACH MARINA

PROPOSED MARINA EXPANSION

DRAWING No. 217111-101

REV. B

Schedule A, 2018 10.03.18